21–29 Maddox Street

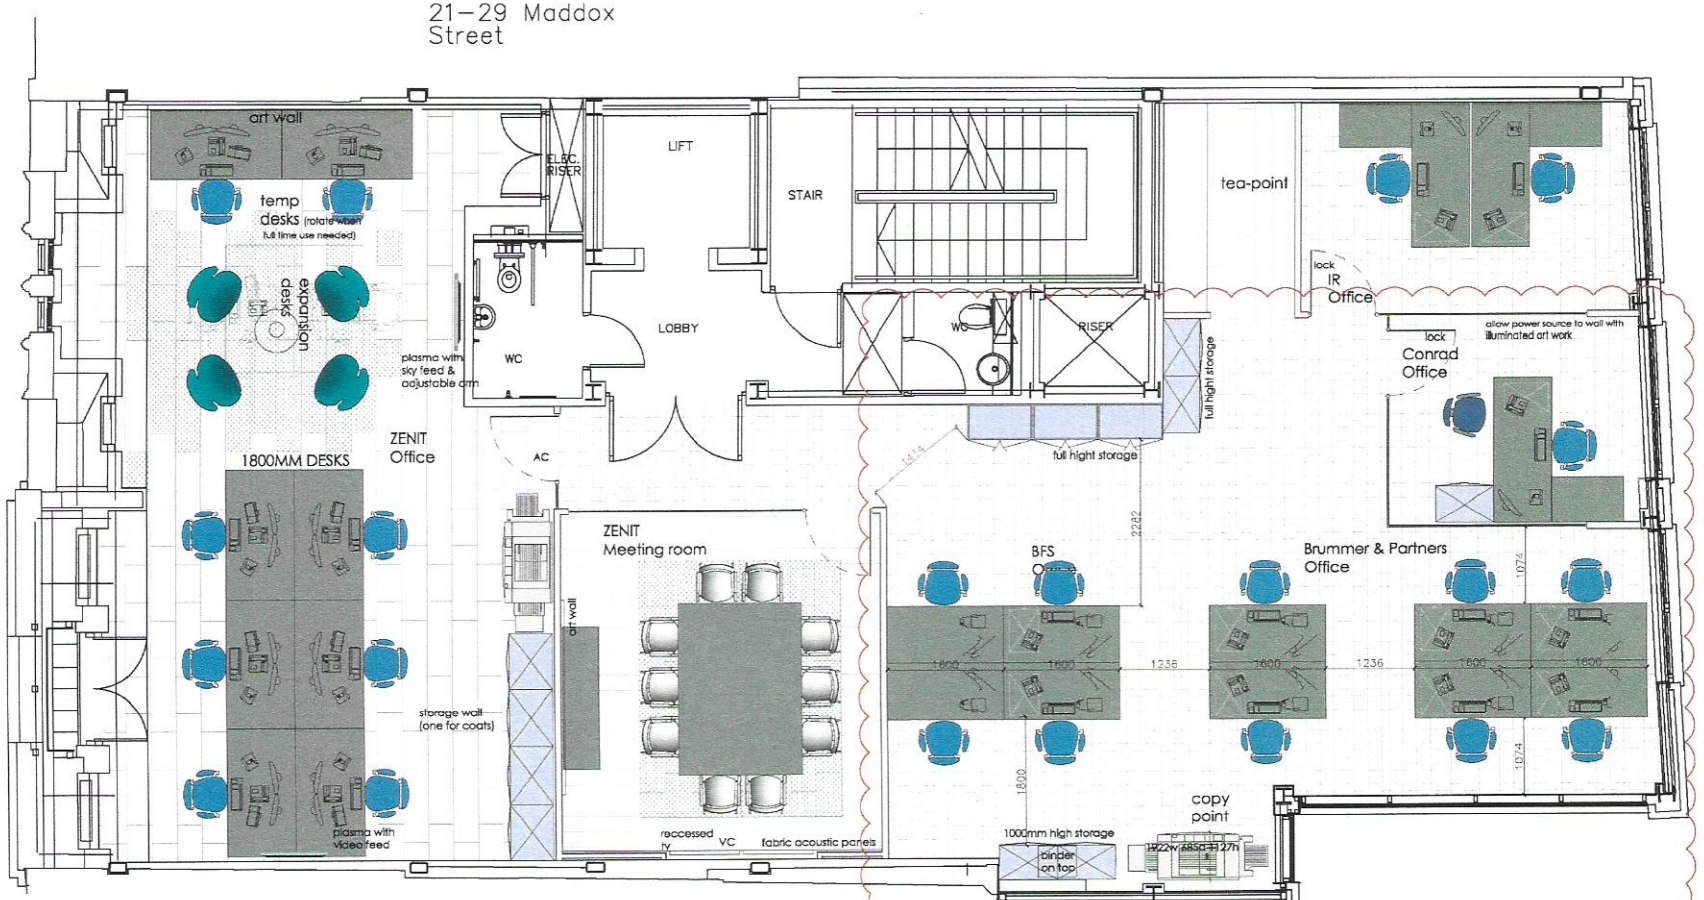

Maddox Street

35–39 Maddox Street

4TH FLOOR

Rev	Revision	By	Date	Chk'd	Date
C	CURVERY REVISED AS PER CLIENTS REQUEST	PV	080514		
B	NOTES ADDED/UPDATED & WALL MOVED	PV	090514		
A	PRELIMINARY ISSUE	PV	070514		

CLIENT: BRUMMER & PARTNERS

ADDRESS: 31-34 MADDOX STREET LONDON

bluu

DESIGN BY	-	PE
DATE	-	06/05/2014
SCALE	-	1:50@A2
CAD BY	-	PV
SIGN OFF	-	PE

TITLE: 4th FLOOR GENERAL LAYOUT

Dwg No: 14.00XX - 4 - GL C

Bluu Solutions, Princess House, 50-60 Eastcastle Street London W1W 8EA, T: +44 (0)20 7079 3460, F: +44 (0)20 7323 1725

Card Stock
Status: For Information / For Tender / For construction / As built drawing
copyright bluu.